PARTIAL BOUNDARY SURVEYS
BEAVER RESERVOIR
WHITE RIVER, ARKANSAS

FRAC SEC. 3, T 16 N, R 29 W COUNTY WASHINGTON

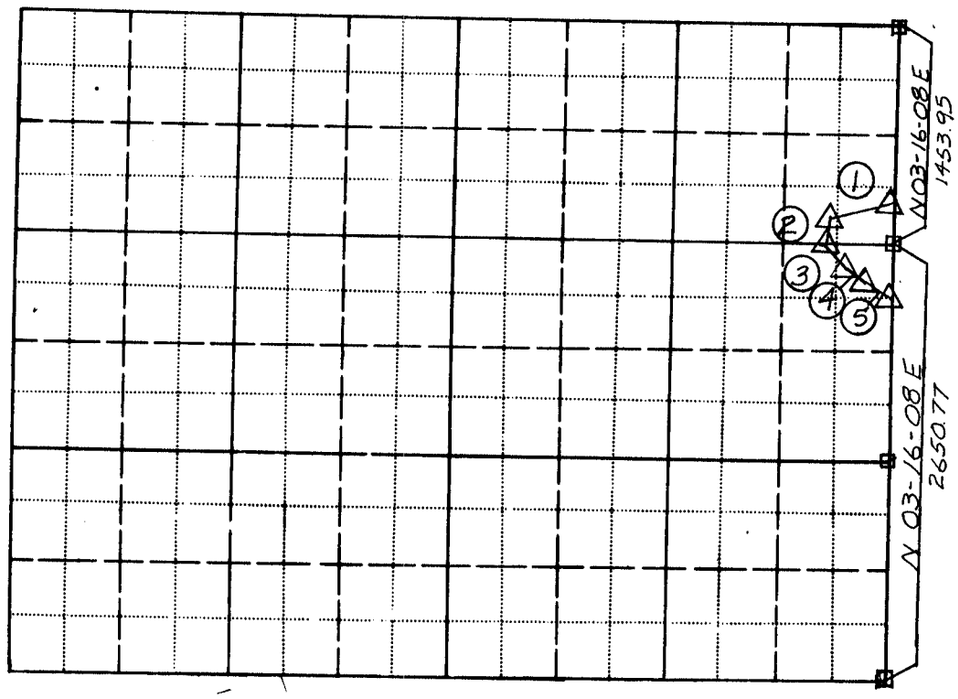

FULL SEC. APPROX. SCALE 1:12,000

TRACT NO.	COURSE NO.	MONUMENT NO.	ANGLE / GRID BEARING	ELEVATION / DISTANCE	POSITION NORTH	POSITION EAST	REMARKS
		2310-2-2		1135.44	645,404.70	1,399,467.62	△ no record-assume Type 3
	1		S62-18-14W	63.86			
		2310-2-2A		1143.51	645,375.01	1,399,411.06	△ no record assumed Type 3
	1		S62-18-14W	97.46			
		2310-2-2B		1142.92	645,329.69	1,399,324.73	△ no record assumed Type 3
	1		S62-18-14W	123.85			
		2310-2-3			645,271.73	1,399,212.47	NOT SET - IN ℄ WHITE RIVER
	2		S03-16-08W	100.00			

CERTIFICATE OF SURVEY

I HEREBY CERTIFY THAT THE ABOVE PLAT IS A TRUE AND CORRECT REPRESENTATION OF THE SURVEY MADE IN SECTION _____, T _____, R _____.

_____

COUNTY, ARKANSAS

Field Book No. ~~68-B-6~~ 68-B-5 68-B-7 68-B-8 68-B-4 TRANSIT CHAIN TRANSIT CHAIN LEVEL Date: MAY 1968

U. S. ARMY ENGINEER DISTRICT, LITTLE ROCK
CORPS OF ENGINEERS

SHEET 1 of 2

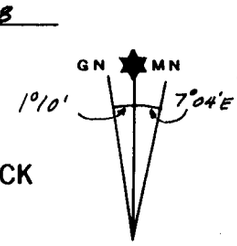

LEGEND

- ▲ - MONUMENT TYPE 1
- △ - MONUMENT TYPE 3
- ● - FOUND I. P.
- ○ - SET I. P.
- ■ - FOUND STONE
- □ - COMPUTED CORNER
- ✱ - OTHER

PARTIAL BOUNDARY SURVEYS
BEAVER RESERVOIR
WHITE RIVER, ARKANSAS

SEC. 3, T 16N, R 29W COUNTY WASHINGTON

TRACT NO.	COURSE NO.	MONUMENT NO.	GRID BEARING	ELEVATION DISTANCE	POSITION NORTH	POSITION EAST	REMARKS
		~~2310-2-4~~ 2311-13			645,171.88	1,399,209.35	△ no record assumed Type 3
	3		S38-51-50E	51.19			
		2311-12A			645,132.02	1,399,241.47	△ with 24" I. rod
	3		S38-51-50E	124.37			
		2311-12			645,035.18	1,399,319.51	△ with 24" I. rod
	4		S33-48-21E	169.63			
		2311-11			644,903.52	1,399,404.49	NOT SET - IN WATER
	5		S45-49-00E	220.91			
		2311-10			644,749.76	1,399,562.70	△ with 24" I. rod

SHEET 2 of 2

SWL FORM 136
REVISED FEB 66