PARTIAL BOUNDARY SURVEYS
DARDANELLE RESERVOIR
ARKANSAS RIVER, ARKANSAS

SEC. 23, T 8 N, R 22 W COUNTY LOGAN

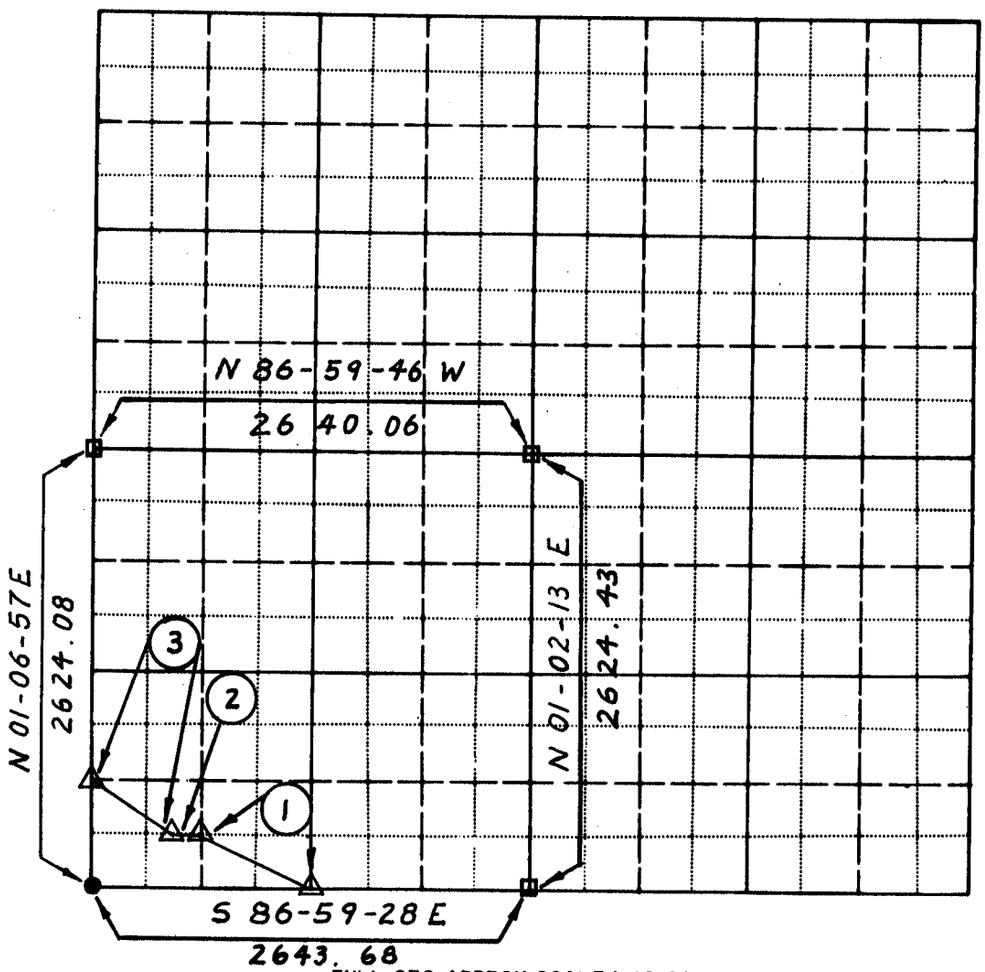

FULL SEC. APPROX. SCALE 1:12,000

TRACT NO.	COURSE NO.	MONUMENT NO.	ANGLE	ELEVATION	POSITION		REMARKS
			GRID BEARING	DISTANCE	NORTH	EAST	
		710-3			364,526.38	1,609,524.98	NOT SET (LAKE
	1		N 60-49-14W	747.49			
		710-4			364,890.96	1,608,872.09	// // //
	2		N 86-58-57W	166.61			
		710-5			364,899.73	1,608,705.71	// // //
	3		N 53-53-25W	603.92			
		710-6			365,255.64	1,608,217.81	// // //

CERTIFICATE OF SURVEY

I HEREBY CERTIFY THAT THE ABOVE PLAT IS A TRUE AND CORRECT REPRESENTATION OF THE SURVEY MADE IN SECTION _____, T _____, R _____.

_____

COUNTY, ARKANSAS

Field Book No. 72-D-16-A Date: 1973
73-D-13
73-D-16-B
73-D-6

U. S. ARMY ENGINEER DISTRICT, LITTLE ROCK
CORPS OF ENGINEERS

SHEET _____ of _____

GN MN

LEGEND

- ▲ - MONUMENT TYPE 1
- △ - MONUMENT TYPE 3
- ● - FOUND I. P.
- ○ - SET I. P.
- ■ - FOUND STONE
- □ - COMPUTED CORNER
- ✱ - OTHER

BOUNDARY SURVEYS
LAKE DARDANELLE
ARKANSAS RIVER, ARKANSAS

SECTION 23, T 8N, R 22W COUNTY Johnson

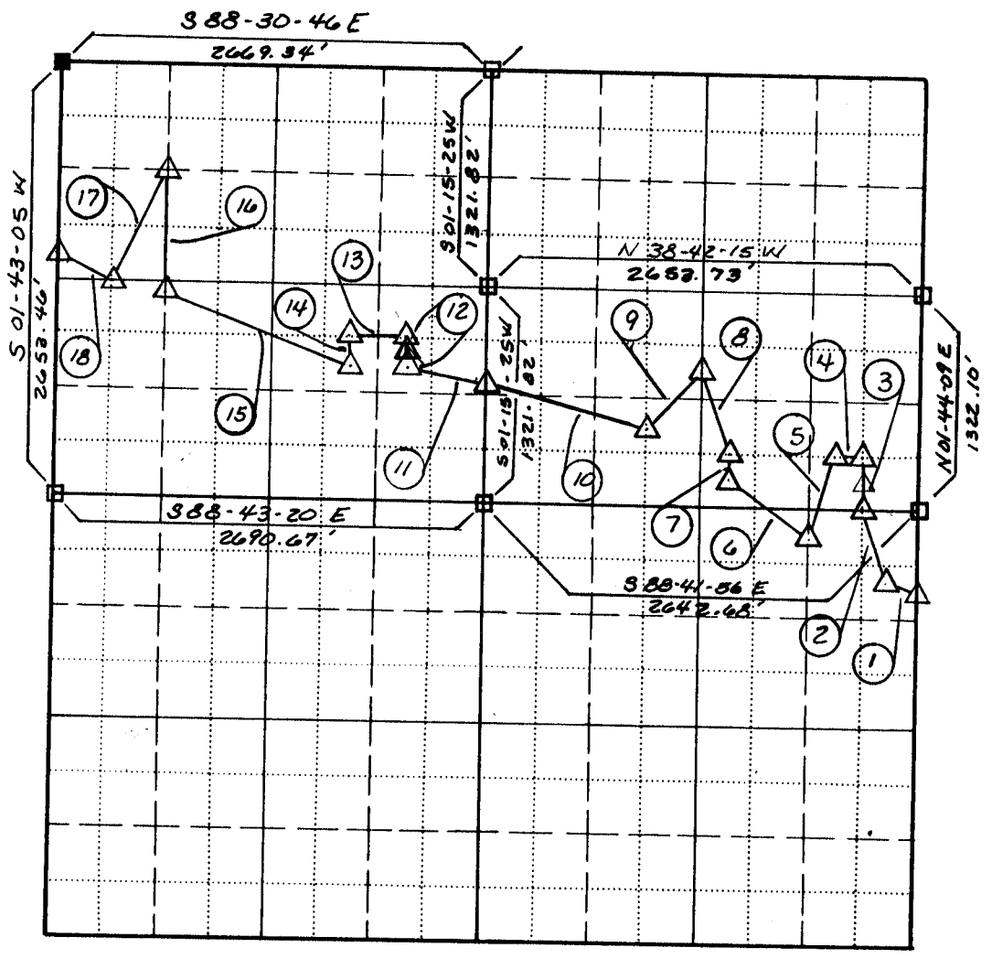

FULL SECTION APPROXIMATE SCALE 1:12,000

COURSE NO.	MONUMENT NO.	GRID BEARING	ELEVATION / DISTANCE	POSITION NORTH	POSITION EAST	REMARKS
	711-33 = 712-1		354.191	365,580.52	1,612,667.91	Type 3
1		N65-44-04W	180.89'			
	712-2		352.691	365,654.86	1,612,503.00	Type 3
2		N27-17-24W	340.61'			
	712-3		359.427	365,957.56	1,612,346.83	Type 3
3		N01-41-20E	199.95'			
	712-3A		363.007	366,157.42	1,612,352.72	Type 3
3		N01-41-25E	130.56'			

CERTIFICATE OF SURVEY

I HEREBY CERTIFY THAT THE ABOVE PLAT IS A TRUE AND CORRECT REPRESENTATION OF THE SURVEY MADE IN SECTION _____, T _____, R _____.

_____
COUNTY, ARKANSAS

_____ _____
SURVEYOR REG. NO.

Field Book No. 73D-11, 73D-19, 73D-20 Date: 1973

GN MN

LEGEND
- ▲ MONUMENT TYPE 1
- △ MONUMENT TYPE 2
- ● FOUND I. P.
- ○ SET I. P.
- ■ FOUND STONE
- □ COMPUTED CORNER
- ✱ OTHER

U. S. ARMY ENGINEER DISTRICT, LITTLE ROCK
CORPS OF ENGINEERS

SHEET 1 OF 2

PARTIAL BOUNDARY SURVEYS
DARDANELLE RESERVOIR
ARKANSAS RIVER, ARKANSAS

SEC. 23, T 8 N, R 22 W COUNTY Johnson

TRACT NO.	COURSE NO.	MONUMENT NO.	ANGLE / GRID BEARING	ELEVATION / DISTANCE	POSITION / NORTH	POSITION / EAST	REMARKS
		712-4		360.446	366,287.92	1,612,356.57	Type-3
	4		N88-41-20 W	165.34'			
		712-5		373.106	366,291.70	1,612,191.27	Type 3
	5		S22-30-20 W	463.90'			
		712-6		356.509	365,863.13	1,612,013.70	"
	6		N65-01-08 W	540.47'			
		712-7		343.152	366,091.38	1,611,523.79	"
	7		~~S~~N01-41-39 ~~W~~E	215.21'			
		712-8		366.192	366,306.50	1,611,530.15	"
	8		N16-58-13 W	522.04'			
		712-9 = 713-1		345.363	366,805.70	1,611,377.96	"
	9		S31-23-30 W	662.95'			
		713-2		365.046	366,239.79	1,611,032.64	"
	10		Along north R-O-W of RR				
		713-3 = 714-1					Not set
	11		Along north R-O-W of RR				
		714-2			366,762.99	1,609,555.03	Type 3
	12		N01-20-23 E	68.83'			
		714-2A		384.876	366,831.80	1,609,556.64	"
	12		N01-20-23E	183.27'			
		714-3		377.434	367,015.02	1,609,560.92	"
	13		N88-37-57 W	330.00'			
		714-4		378.249	367,022.89	1,609,231.02	"
	14		S04-24-43 W	62.10'			
		714-5		360.925	366,960.97	1,609,226.24	"
	15						
		714-6		359.242			Not set
	16						
		714-7		363.700	368,045.51	1,608,064.49	Type 3
	17		S 74-27-12 W	345.72'			
		714-8		361.025	367,952.85	1,607,731.42	Type 3

SHEET 2 of 2

SWL FORM 136
REVISED FEB. 66